




VENT STACK
DIA: 305mm/200mm HT 15,000 mm
DESIGN: 7.0 BARG, -42/60C°

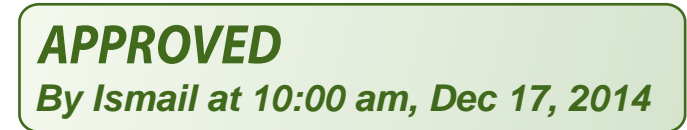

NOTE (S): 1. REFER P & ID 3563-R-DB-0000-002 FOR LEGEND AND GENERAL NOTES. 2. FLAME ARRESTER WILL BE INSTALLED AT THE END OF LINE. 3. SPRING LOADED BALL VALVE WITH 90° ROTATION. 4. IMPINGING PLATE ROTATION.	11	24.09.09	AS BUILT	SZH		BIK		-		 DESCON ENGINEERING LTD. P.O. BOX 1201, LAHORE 54000, PAKISTAN	CLIENT  ENGRO PAKTANK TERMINAL LTD.				PROJECT LPG STORAGE & HANDLING TITLE P & ID STACK SYSTEM				SHEET NO. 1 OF 1				REV. 11					
	10	29.12.03	SECOND AS BUILT	MAA		IU		SNR																				
	9	4.7.2K	FIRST AS BUILT	MIM		IU		SNR																				
	8	06-12-99	AS BUILT	YM		ZM		IA																				
	7	30-12-98	ISSUED FOR CONSTRUCTION	RZA		ZM		MH																				
	6	15-12-98	ISSUED FOR CONSTRUCTION	YM		ZM		MH																				
	REV	DATE	DESCRIPTION	INIT.	SIGN	INIT.	SIGN	INIT.	SIGN	ORIGINAL ENGINEERED DRAWN CHECKED APPROVED				E.F. NAME L4R012K SIZE SCALE A3 NTS				EPTL DOC. NO. DR01209				DOCUMENT NUMBER 3563-R-DB-0000-012-*				SHEET NO. OF 1 1		REV. 11
	REVISIONS									THIS DOCUMENT HAS BEEN MODIFIED MANUALLY <input type="checkbox"/> YES <input checked="" type="checkbox"/> NO																		
	UNAUTHORIZED REPRODUCTION OF ANY KIND IS PROHIBITED; ALL RIGHTS ARE RESERVED BY DESCON ENGINEERING LIMITED, LAHORE, PAKISTAN																											