


V-201E/F  
LPG STORAGE BULLETS  
CAPACITY: 500 TONS  
DIM: DIA 5000mm,LENGTH 53200mm (T/T)  
DESIGN: 17.2 PSIG, -10/60°C



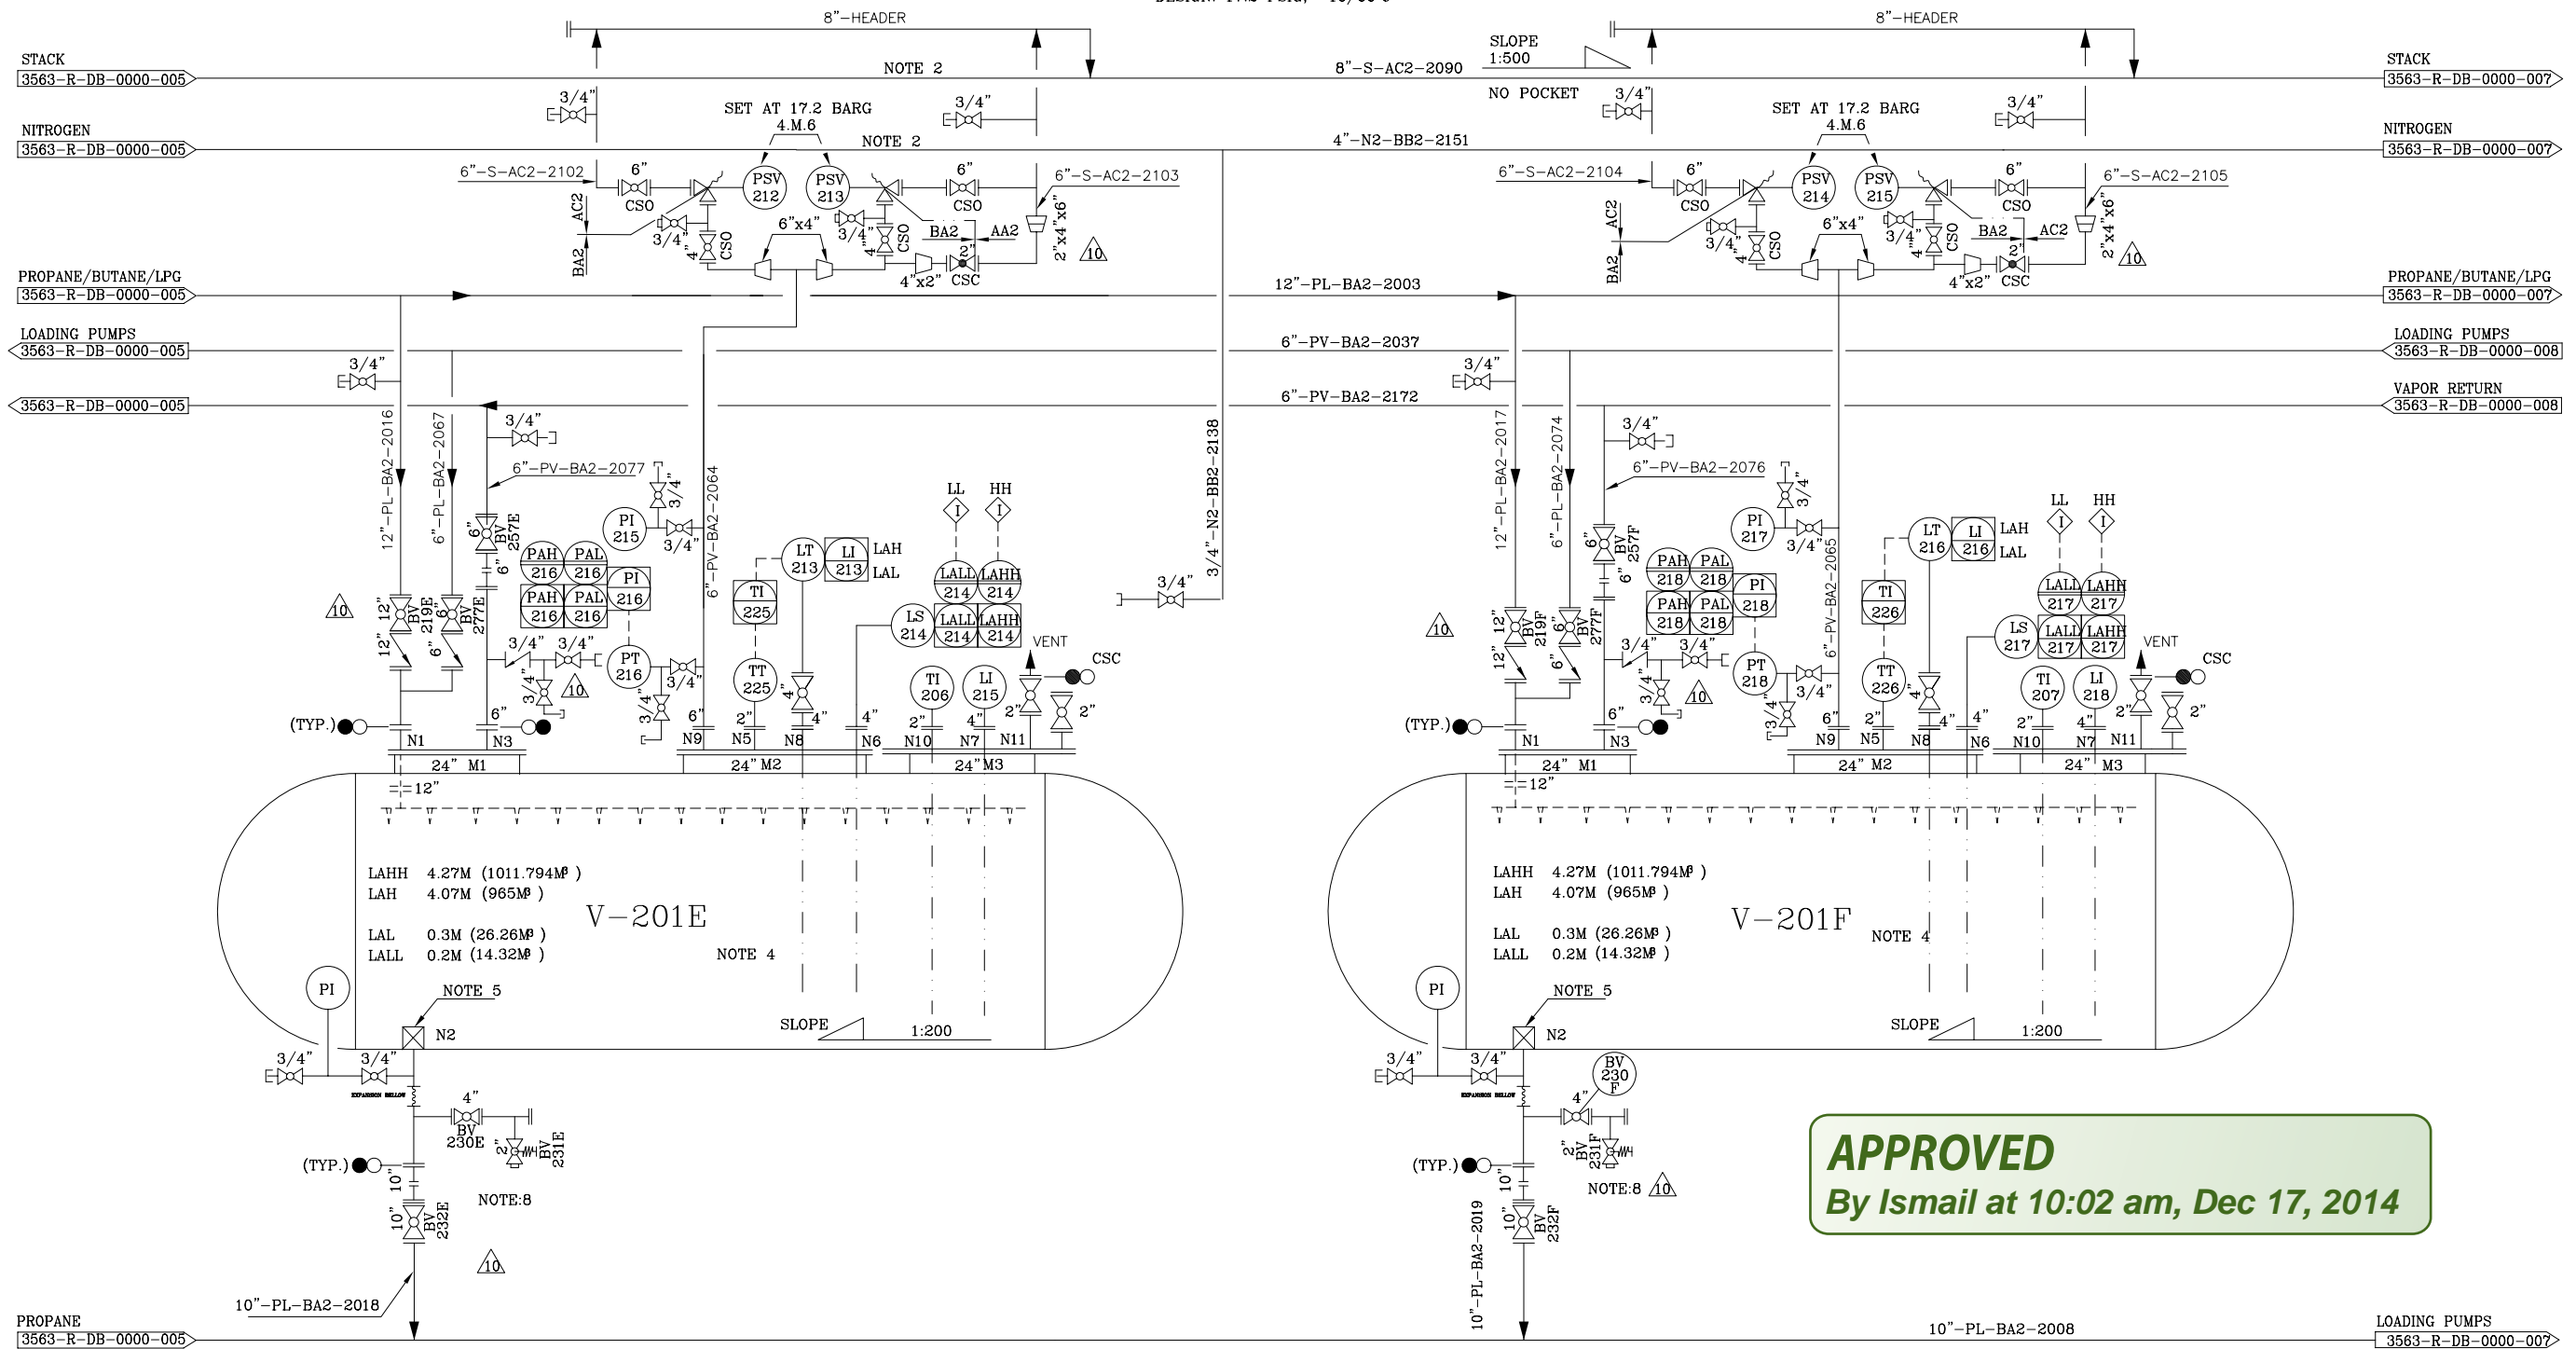

**APPROVED**  
By Ismail at 10:02 am, Dec 17, 2014

NOTE(S):

- 1-REFER P & ID 3563-R-DB-0000-002 FOR LEGEND AND GENERAL NOTES
- 2-ALL CONNECTIONS FROM TOP OF HEADER
- 3-MANHOLES EXTENDED OUTSIDE THE EARTH MOUND
- 4-VESSELS WITH 1.0M MIN. EARTH MOUNDING
- 5-VORTEX BREAKER SHOULD BE INSTALLED.
- 6-SPRING LOADED BALL VALVE WITH 90° ROTATION.

13	28.09.09	AS BUILT	SZH	BIK	-	
12	17.12.03	SECOND AS BUILT	MAA	IU	SNR	
11	3.7.2K	FIRST AS BUILT	MIM	IU	SNR	
10	06-12-99	AS BUILT	YM	ZM	IA	
9	09-02-99	AS MARKED	YM	ZM	MH	
8	06-02-99	AS MARKED	YM	ZM	MH	
REV	DATE	DESCRIPTION	INIT. BY	SIGN	INIT. BY	SIGN
REVISIONS						
UNAUTHORIZED REPRODUCTION OF ANY KIND IS PROHIBITED; ALL RIGHTS ARE RESERVED BY DESCON ENGINEERING LIMITED, LAHORE, PAKISTAN						

DESCON ENGINEERING LTD. P.O. BOX 1201, LAHORE 54000, PAKISTAN						
ORIGINAL	INIT.	SIGN	DATE	E.F.	NAME	
ENGINEERED	RZA		6/12		L4R006M	
DRAWN	YM		6/12		SIZE	SCALE
CHECKED	ZM		6/12		A3	NTS
APPROVED	IA		6/12			
THIS DOCUMENT HAS BEEN MODIFIED MANUALLY				EPTL DOC. NO.		DOCUMENT NUMBER
<input type="checkbox"/> YES <input checked="" type="checkbox"/> NO				DR 00611		3563-R-DB-0000-006-*
				SHEET	REV.	
				NO. 1	OF 1	14

CLIENT					ENGRO PAKTANK		
					TERMINAL LTD		
PROJECT LPG STORAGE & HANDLING							
TITLE							
P & ID							
PROPANE/BUTANE STORAGE							
E	DOCUMENT NUMBER				SHEET		REV.
	3563-R-DB-0000-006-*				NO.	OF	14
					1	1	