

APPROVED
By Ismail at 9:48 am, Dec 17, 2014

LEGEND

PLC BASED INSTRUMENT LOCAL, PANEL MOUNTED INSTRUMENT

LOCAL, DIRECT MOUNTED INSTRUMENT REMOTE MOUNTED INSTRUMENT

MCC : MOTOR CONTROL CENTRE

CCR : CARGO CONTROL ROOM

PROCESS EQUIPMENT TRIP FUNCTION

LINE CLASSES

1A1 :ANSI 150# RATED SYSTEM, A106 Gr. B CS, MIN. TEMP. -10°C
3A1 :ANSI 300# RATED SYSTEM, A106 Gr. B CS, MIN. TEMP. -10°C

GENERAL NOTES

VENTS / TESTING DRAINS TO BE PLACED IN APPROPRIATE POSITIONS BY OTHERS
I/P'S AND REMOTE OPEN/CLOSE FACILITIES PROVIDED FOR ALL CONTROL VALVES
RUNNING AND FAULT INDICATION PROVIDED FOR ALL MOTORS
IMMERSION HEATERS ARE FITTED WITH HIGH TEMPERATURE CUT OUTS.
ALL PSV AND TSV OUTLETS TO CONNECT INTO TOP OF HEADER

DESIGN DATA				
ITEM No	SERVICE	LENGTH/ BREADTH/ HEIGHT (mm)	DESIGN PRESSURE	DESIGN TEMPERATURE (°C)
V-1501	GLYCOL WATER TANK	2438/1524/ 1219	ATMOSPHERIC	+3/+100
ITEM No	SERVICE	RATED CAPACITY (m ³ /HR)	DIFFERENTIAL HEAD (m)	MAX. DIFF. HEAD (m)
P-1503 A/B	GLYCOL WATER PUMP	40	60	67
ITEM No	SERVICE	DUTY (kW)	DESIGN PRESSURE	AMBIENT AIR TEMPERATURE (°C)
E-1507	EVAPORATIVE COOLER	345	10 bar	+3/+47

NOTES

- AUTOFILL CONNECTION FOR EVAPORATIVE COOLER WATER TOP UP FROM EXISTING FRESHWATER SYSTEM, WITH MECHANICAL MAKE-UP VALVE.
- DRAIN CONNECTION FOR EVAPORATIVE COOLER.
- OVERFLOW CONNECTION FOR EVAPORATIVE COOLER.
- MAKE-UP WATER FROM EXISTING FRESHWATER SYSTEM.
- P-1506B IS AN UNINSTALLED SPARE PUMP.
- IF EITHER FAN FAILS, OTHER FAN AUTOSTARTS
- AUTO SELECTOR SWITCH WHICH ALLOWS FAN MOTORS EM-1506A/B AND PM-1506A TO BE ACTIVATED.

09	05/09/09	AS BUILT	SZH	BIK	-
08		AS BUILT (CR-088)	JS		
07	21/11/08	TAG NUMBERS MODIFIED (CR-079)	JS	JM	JGC
06	12/08/08	VALVES MV-2332 AND MV-2333 MODIFIED (CR-086)	JS	JM	MH
05	08/08/08	CLIENT COMMENTS ADDED & LINE NUMBERING CHANGED (CR-084)	LE	LUC	AGS
04	13/08/08	APPROVED FOR CONSTRUCTION (CR-034 & CR-041)	JS	AGS	AGS
03	14/03/08	APPROVED FOR CONSTRUCTION	JS	LUC	MH
		(CR-023, CR-025 AND CR-032)			
02	23/11/07	HOLDS REMOVED & DESIGN DATA MOD (CR-011)	JS	LUC	MH
01	18/10/07	POST DESIGN REVIEW / HAZOP (CR-002)	JS	LUC	MH
00	20/07/07	FOR DESIGN REVIEW / HAZOP	JS	LC	AJS
REV.	DATE	DESCRIPTION	DRAWN	CHECKED	APPR.

CLIENT
ENGRO VOPAK TERMINAL LIMITED


PROJECT
**ETHYLENE STORAGE AND HANDLING FACILITY
KARACHI, PAKISTAN**

Excellent Engineering Solutions
WEIR
Young House
42 Discovery Terrace
Edinburgh EH14 4AP
Scotland U.K.
Tel. : +44(0)131 317 8787
Fax. : +44(0)131 452 3333
E-mail : info@igeprocess.com

TITLE
**P&I Diagram
GLYCOL WATER HEATING/Cooling**

DRAWING No.	REV.	NEXT SHEET	SCALE	SIZE
07006-PD-10-003-01	09	-	NTS	A1

THIS DOCUMENT IS CONFIDENTIAL. ALL RIGHTS RESERVED. COPYRIGHT © LIQUID GAS EQUIPMENT LTD.
DISTRIBUTION, COPYING OR RETENTION OF THIS DRAWING, WHETHER IN WHOLE OR IN PART AND IRRESPECTIVE OF THE TYPE OF MEDIA ON WHICH IS HELD OR TRANSMITTED, IS PROHIBITED EXCEPT WITH OUR EXPRESS PRIOR WRITTEN CONSENT.

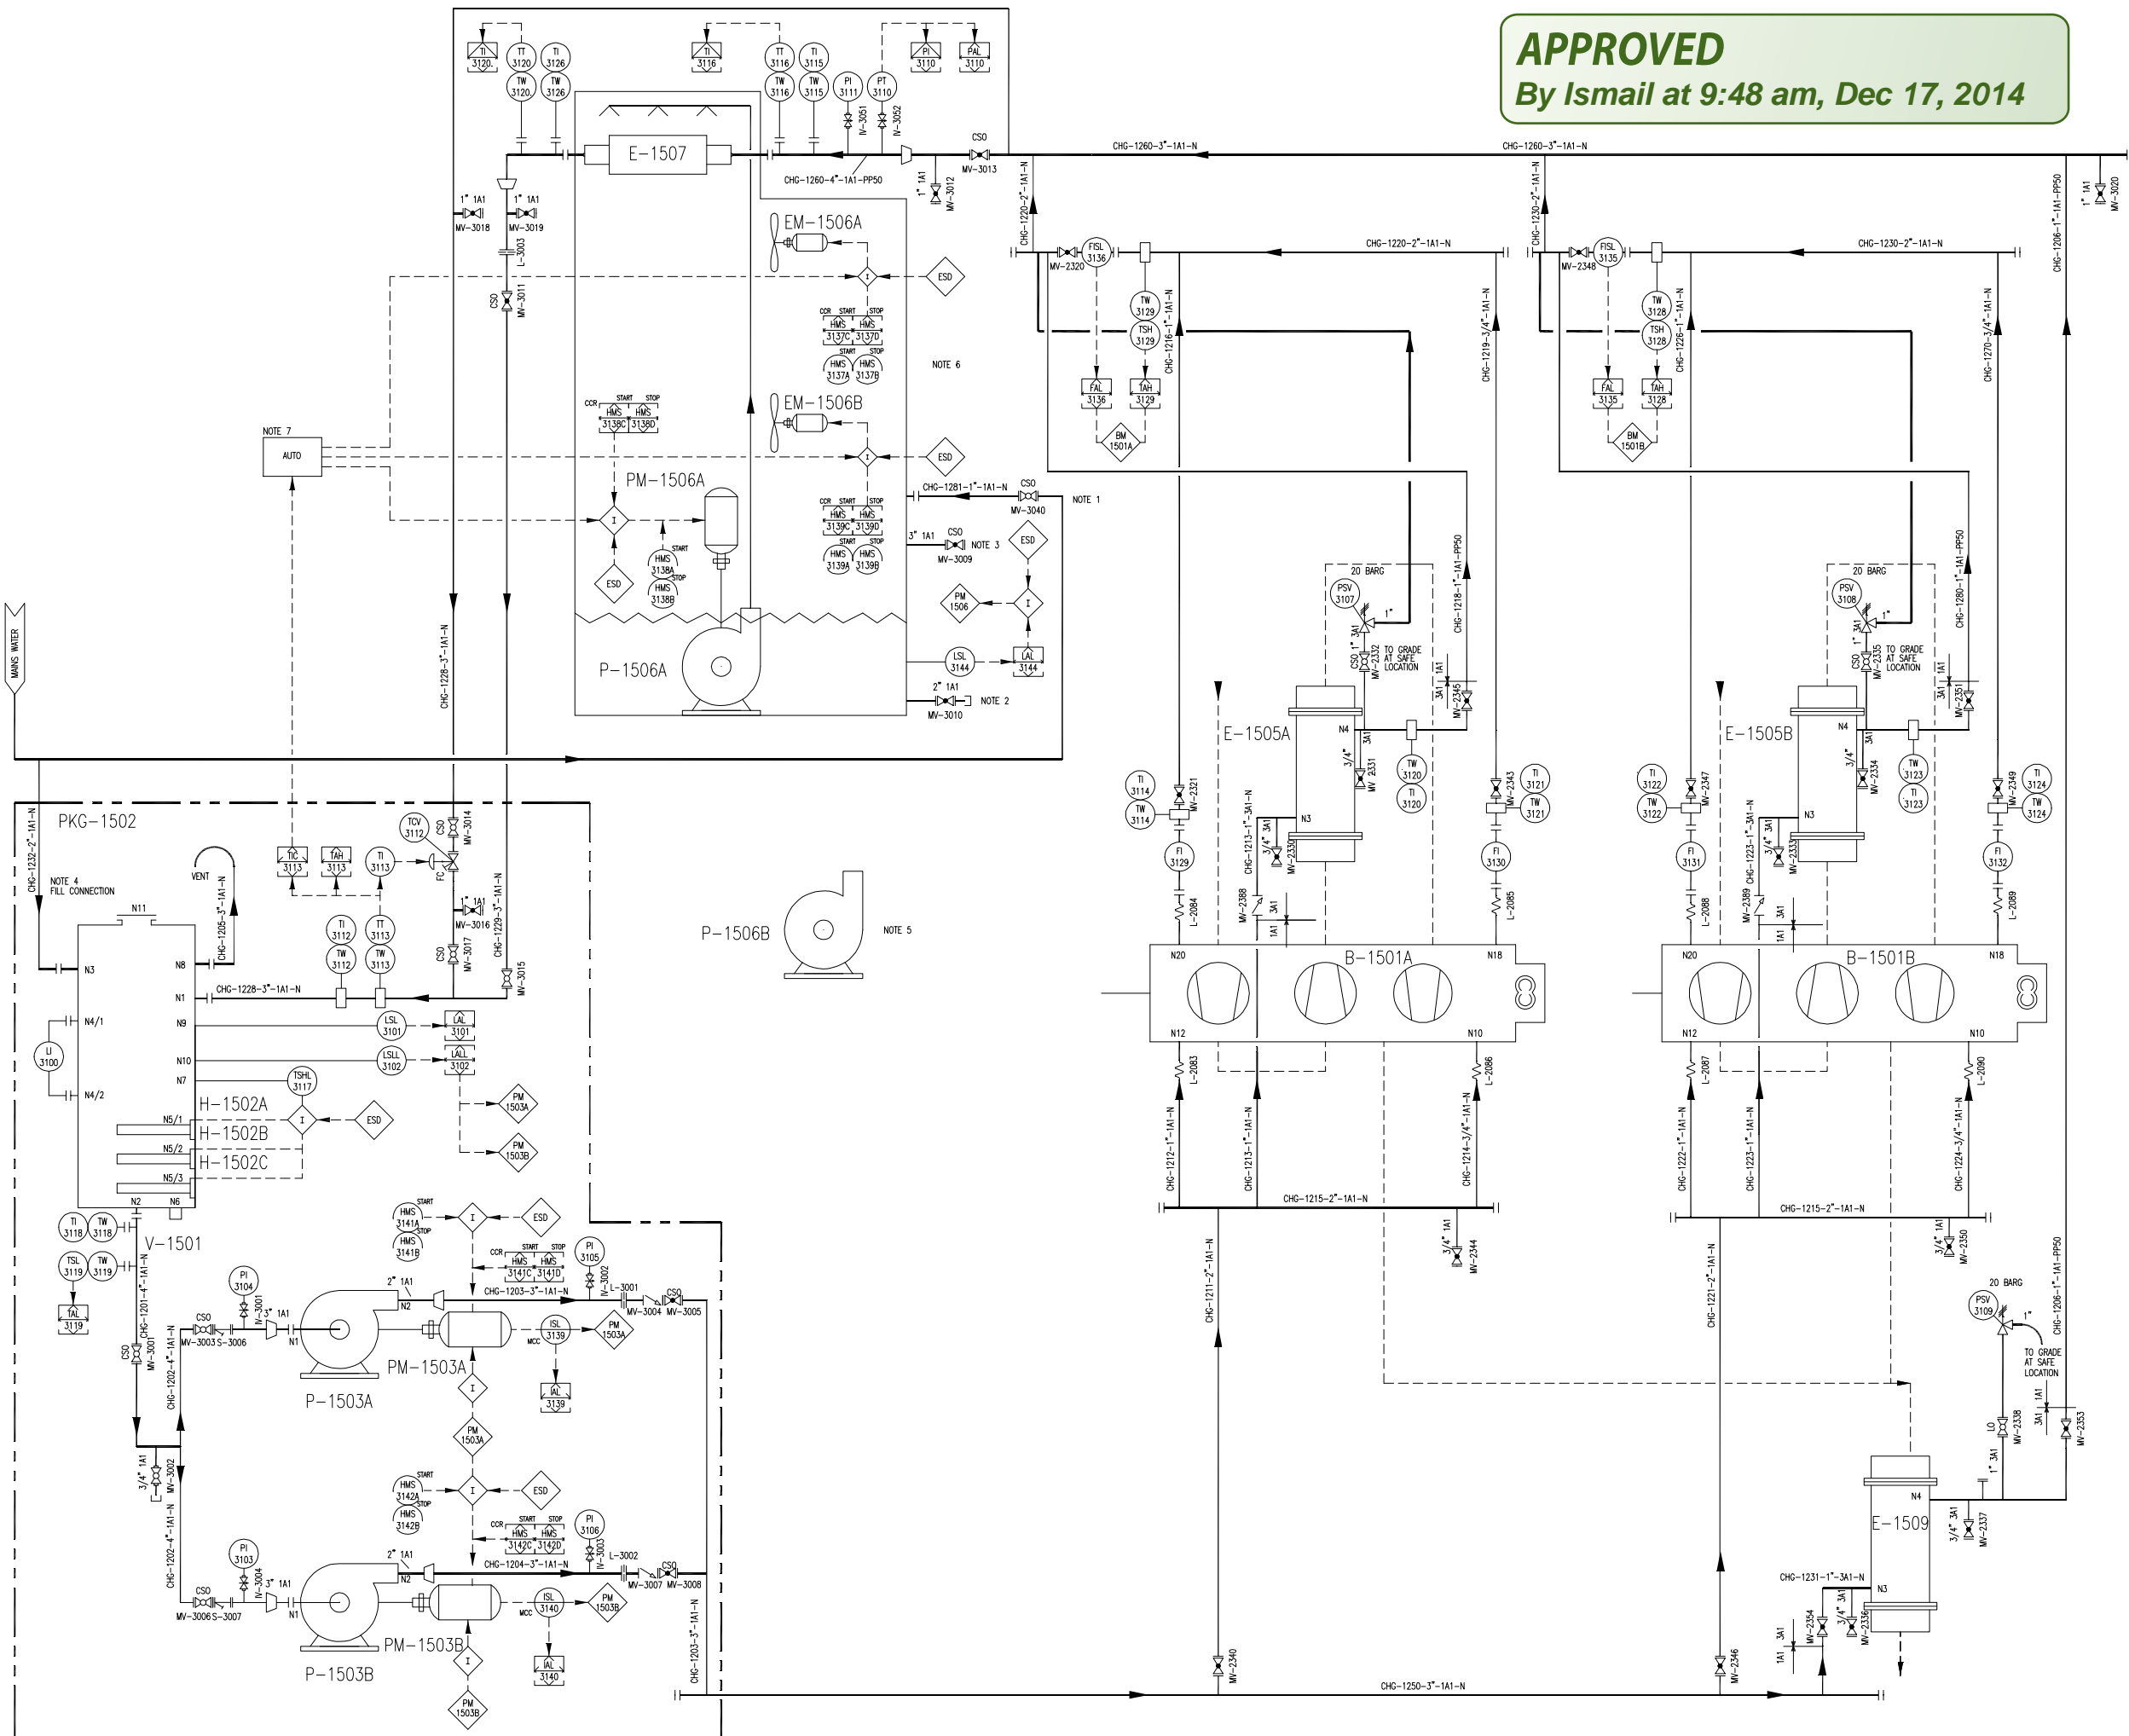

V-1501 GLYCOL WATER TANK
H-1502A/B/C GLYCOL WATER HEATER
P-1503A/B GLYCOL WATER PUMP
PM-1503A/B GLYCOL WATER PUMP MOTOR
E-1507 EVAPORATIVE COOLER
EM-1506A/B EVAPORATIVE COOLER FAN MOTOR
P-1506A/B EVAPORATIVE COOLER PUMP
PM-1506A EVAPORATIVE COOLER PUMP MOTOR
B-1501A/B BOIL-OFF GAS COMPRESSOR
E-1505A/B INTERSTAGE COOLER
E-1509 DISCHARGE DESUPERHEATER