


V-201G/H
LPG STORAGE BULLETS
CAPACITY: 500 TONS
DIM: DIA 5000mm, LENGTH 53200mm (T/T)
DESIGN: 17.2 BARG, -10/60°C

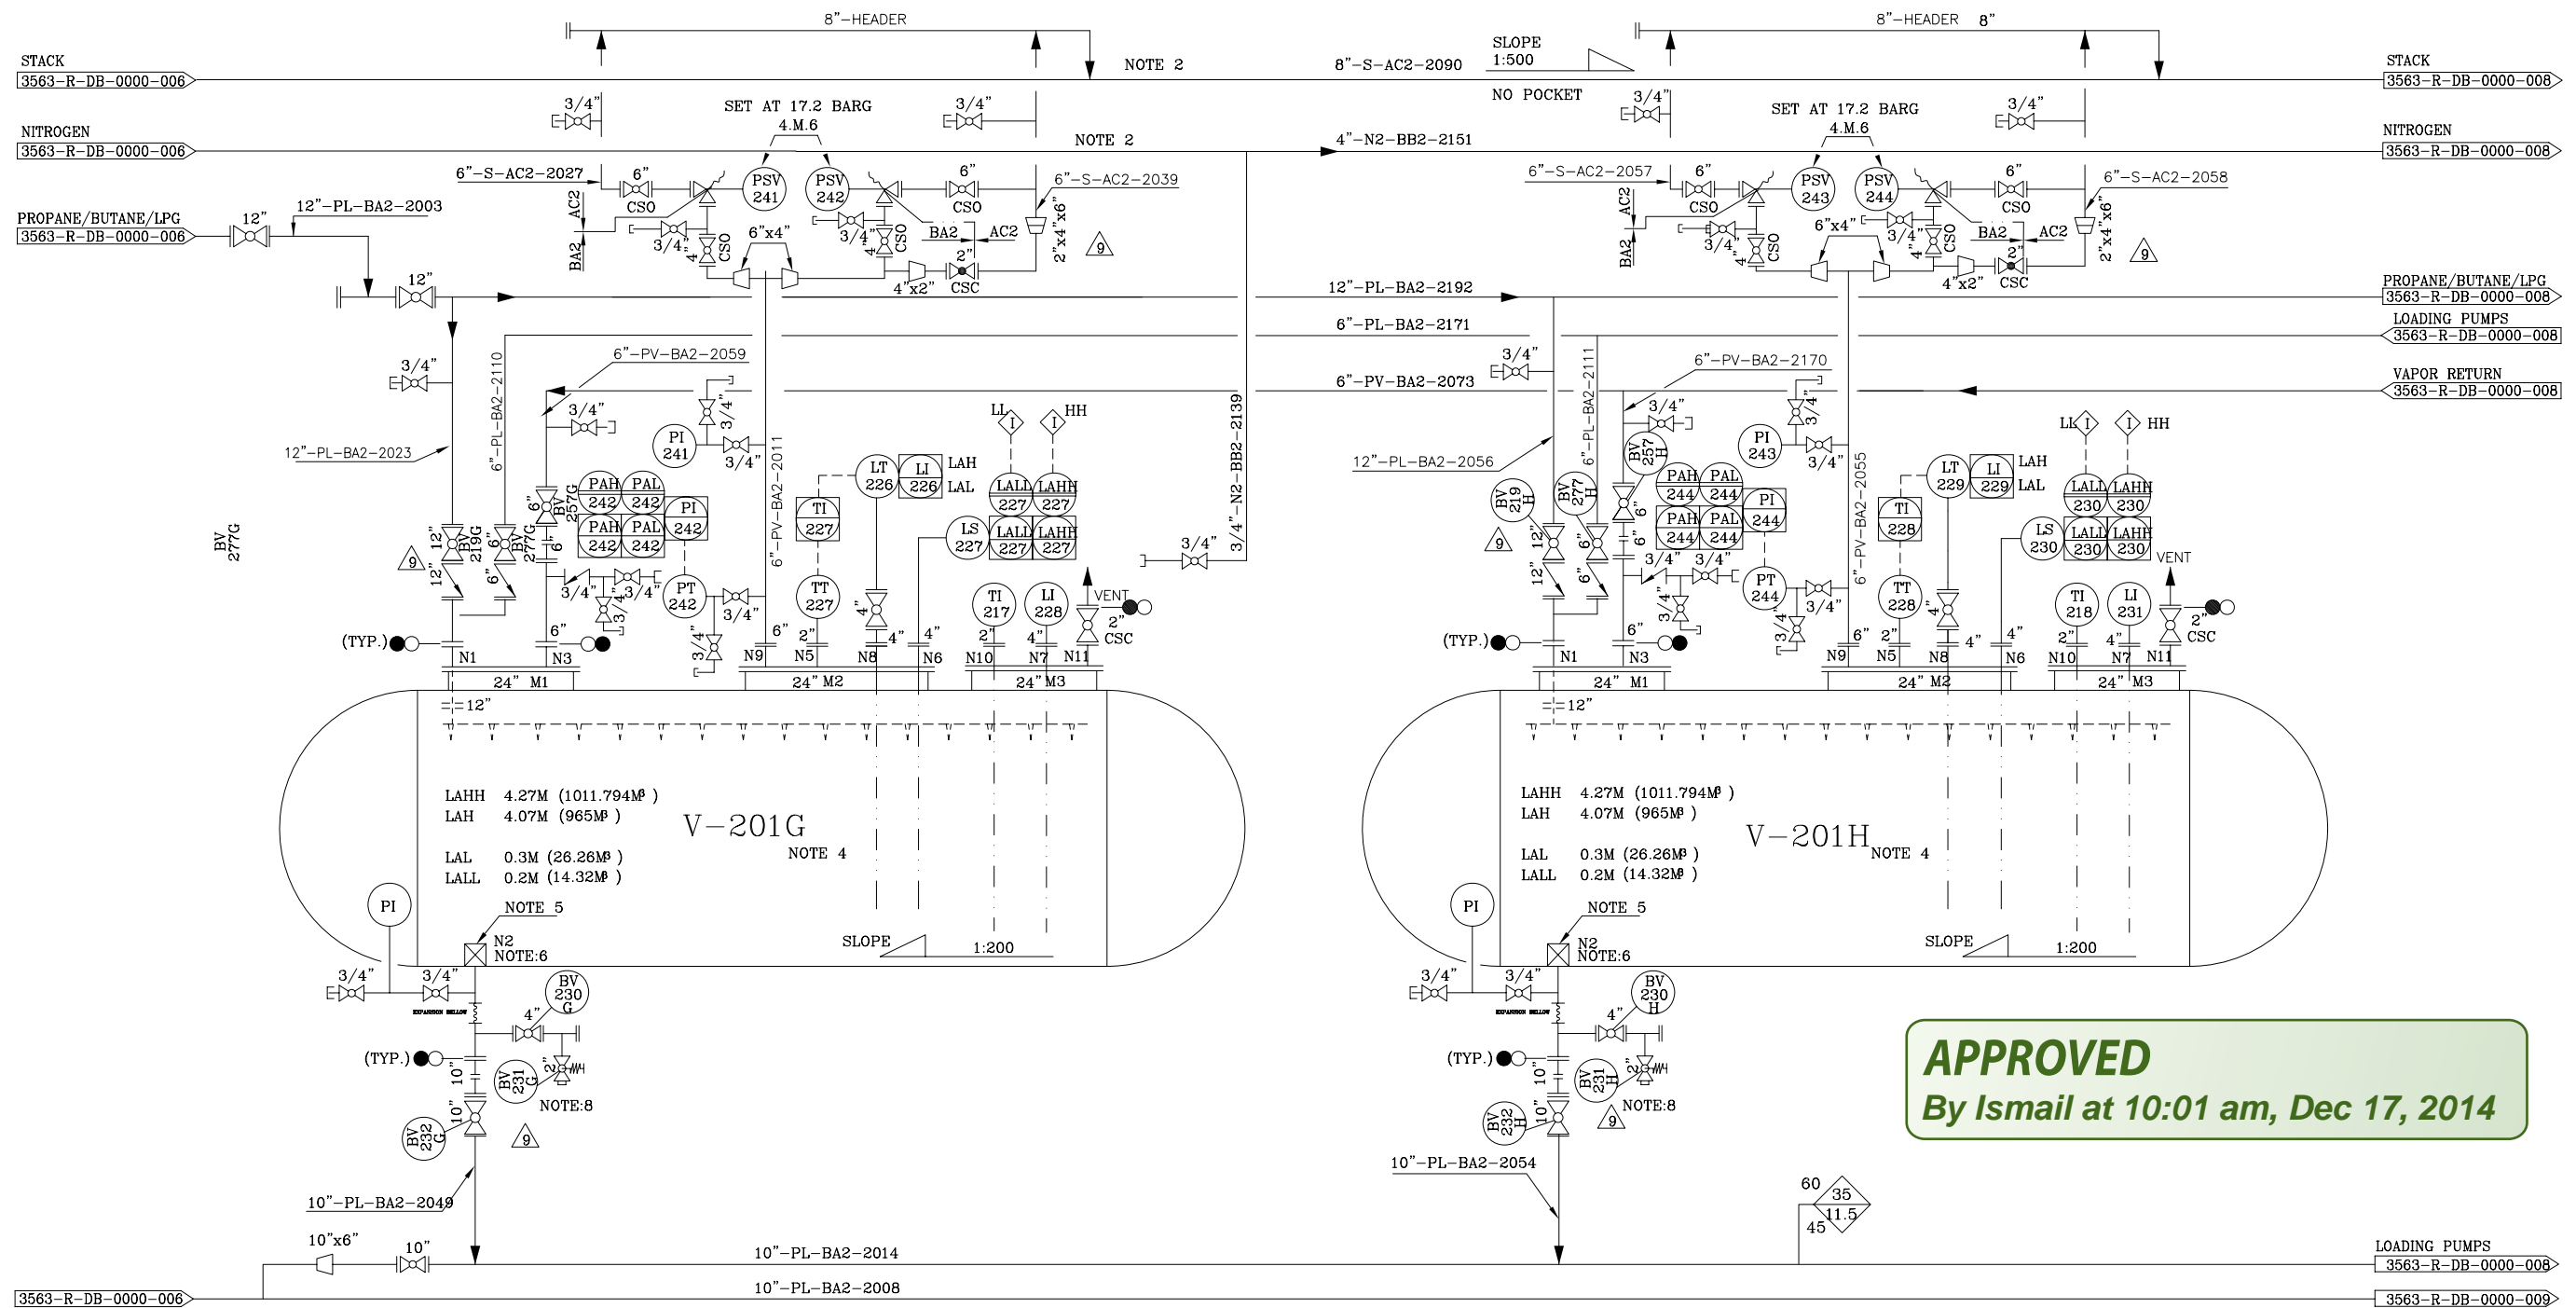

NOTE (S):

- 1-REFER P & ID 3563-R-DB-0000-002 FOR LEGEND AND GENERAL NOTES
- 2-ALL CONNECTIONS FROM THE TOP OF HEADER
- 3-MANHOLES EXTENDED OUTSIDE THE EARTH MOUND
- 4-VESSELS WITH 1.0M MIN. EARTH MOUNDING
- 5-VORTEX BREAKER SHOULD BE INSTALLED.
- 6-NOZZLE N2 WILL BE EXTENDED OUTSIDE THE EARTH MOUND HORIZONTALLY AND THEN VALVES WILL BE INSTALLED FOR ISOLATION AND DRAIN.
- 7-NOZZLE N8 WILL BE EXTENDED INSIDE THE VESSEL.
- 8-SPRING LOADED BALL VALVE WITH 90° ROTATION.

12	28.09.09	AS BUILT	SZH	BIK	-	
11	17.12.03	SECOND AS BUILT	MAA	IU	SNR	
10	3.7.2K	FIRST AS BUILT	MIM	IU	SNR	
9	06-12-99	AS BUILT	YM	ZM	IA	
8	06-02-99	AS MARKED	YM	ZM	MH	
7	01-02-99	ISSUED FOR CONSTRUCTION	YM	ZM	MH	
REV	DATE	DESCRIPTION	INIT. BY	SIGN. CHK'D	INIT. APP'VD	SIGN.

REVISIONS

UNAUTHORIZED REPRODUCTION OF ANY KIND IS PROHIBITED; ALL RIGHTS ARE RESERVED BY DESCON ENGINEERING LIMITED, LAHORE, PAKISTAN

DESCON		DESCON ENGINEERING LTD. P.O. BOX 1201, LAHORE 54000, PAKISTAN			
ORIGINAL	INIT.	SIGN	DATE	E.F.	NAME
ENGINEERED	RZA		6/12		L4R007L
DRAWN	YM		6/12		
CHECKED	ZM		6/12		
APPROVED	IA		6/12		

THIS DOCUMENT HAS BEEN
MODIFIED MANUALLY
☐ YES ☒ NO

EPTL DOC. NO.
DR 00 71 0

CLIENT	ENGRO	ENGRO PAKTANK TERMINAL LTD.
PROJECT	LPG STORAGE & HANDLING	
TITLE	P & ID PROPANE/BUTANE STORAGE	

DOCUMENT NUMBER	3563-R-DB-0000-007-*	SHEET NO.	1	REV.	13
-----------------	----------------------	-----------	---	------	----