





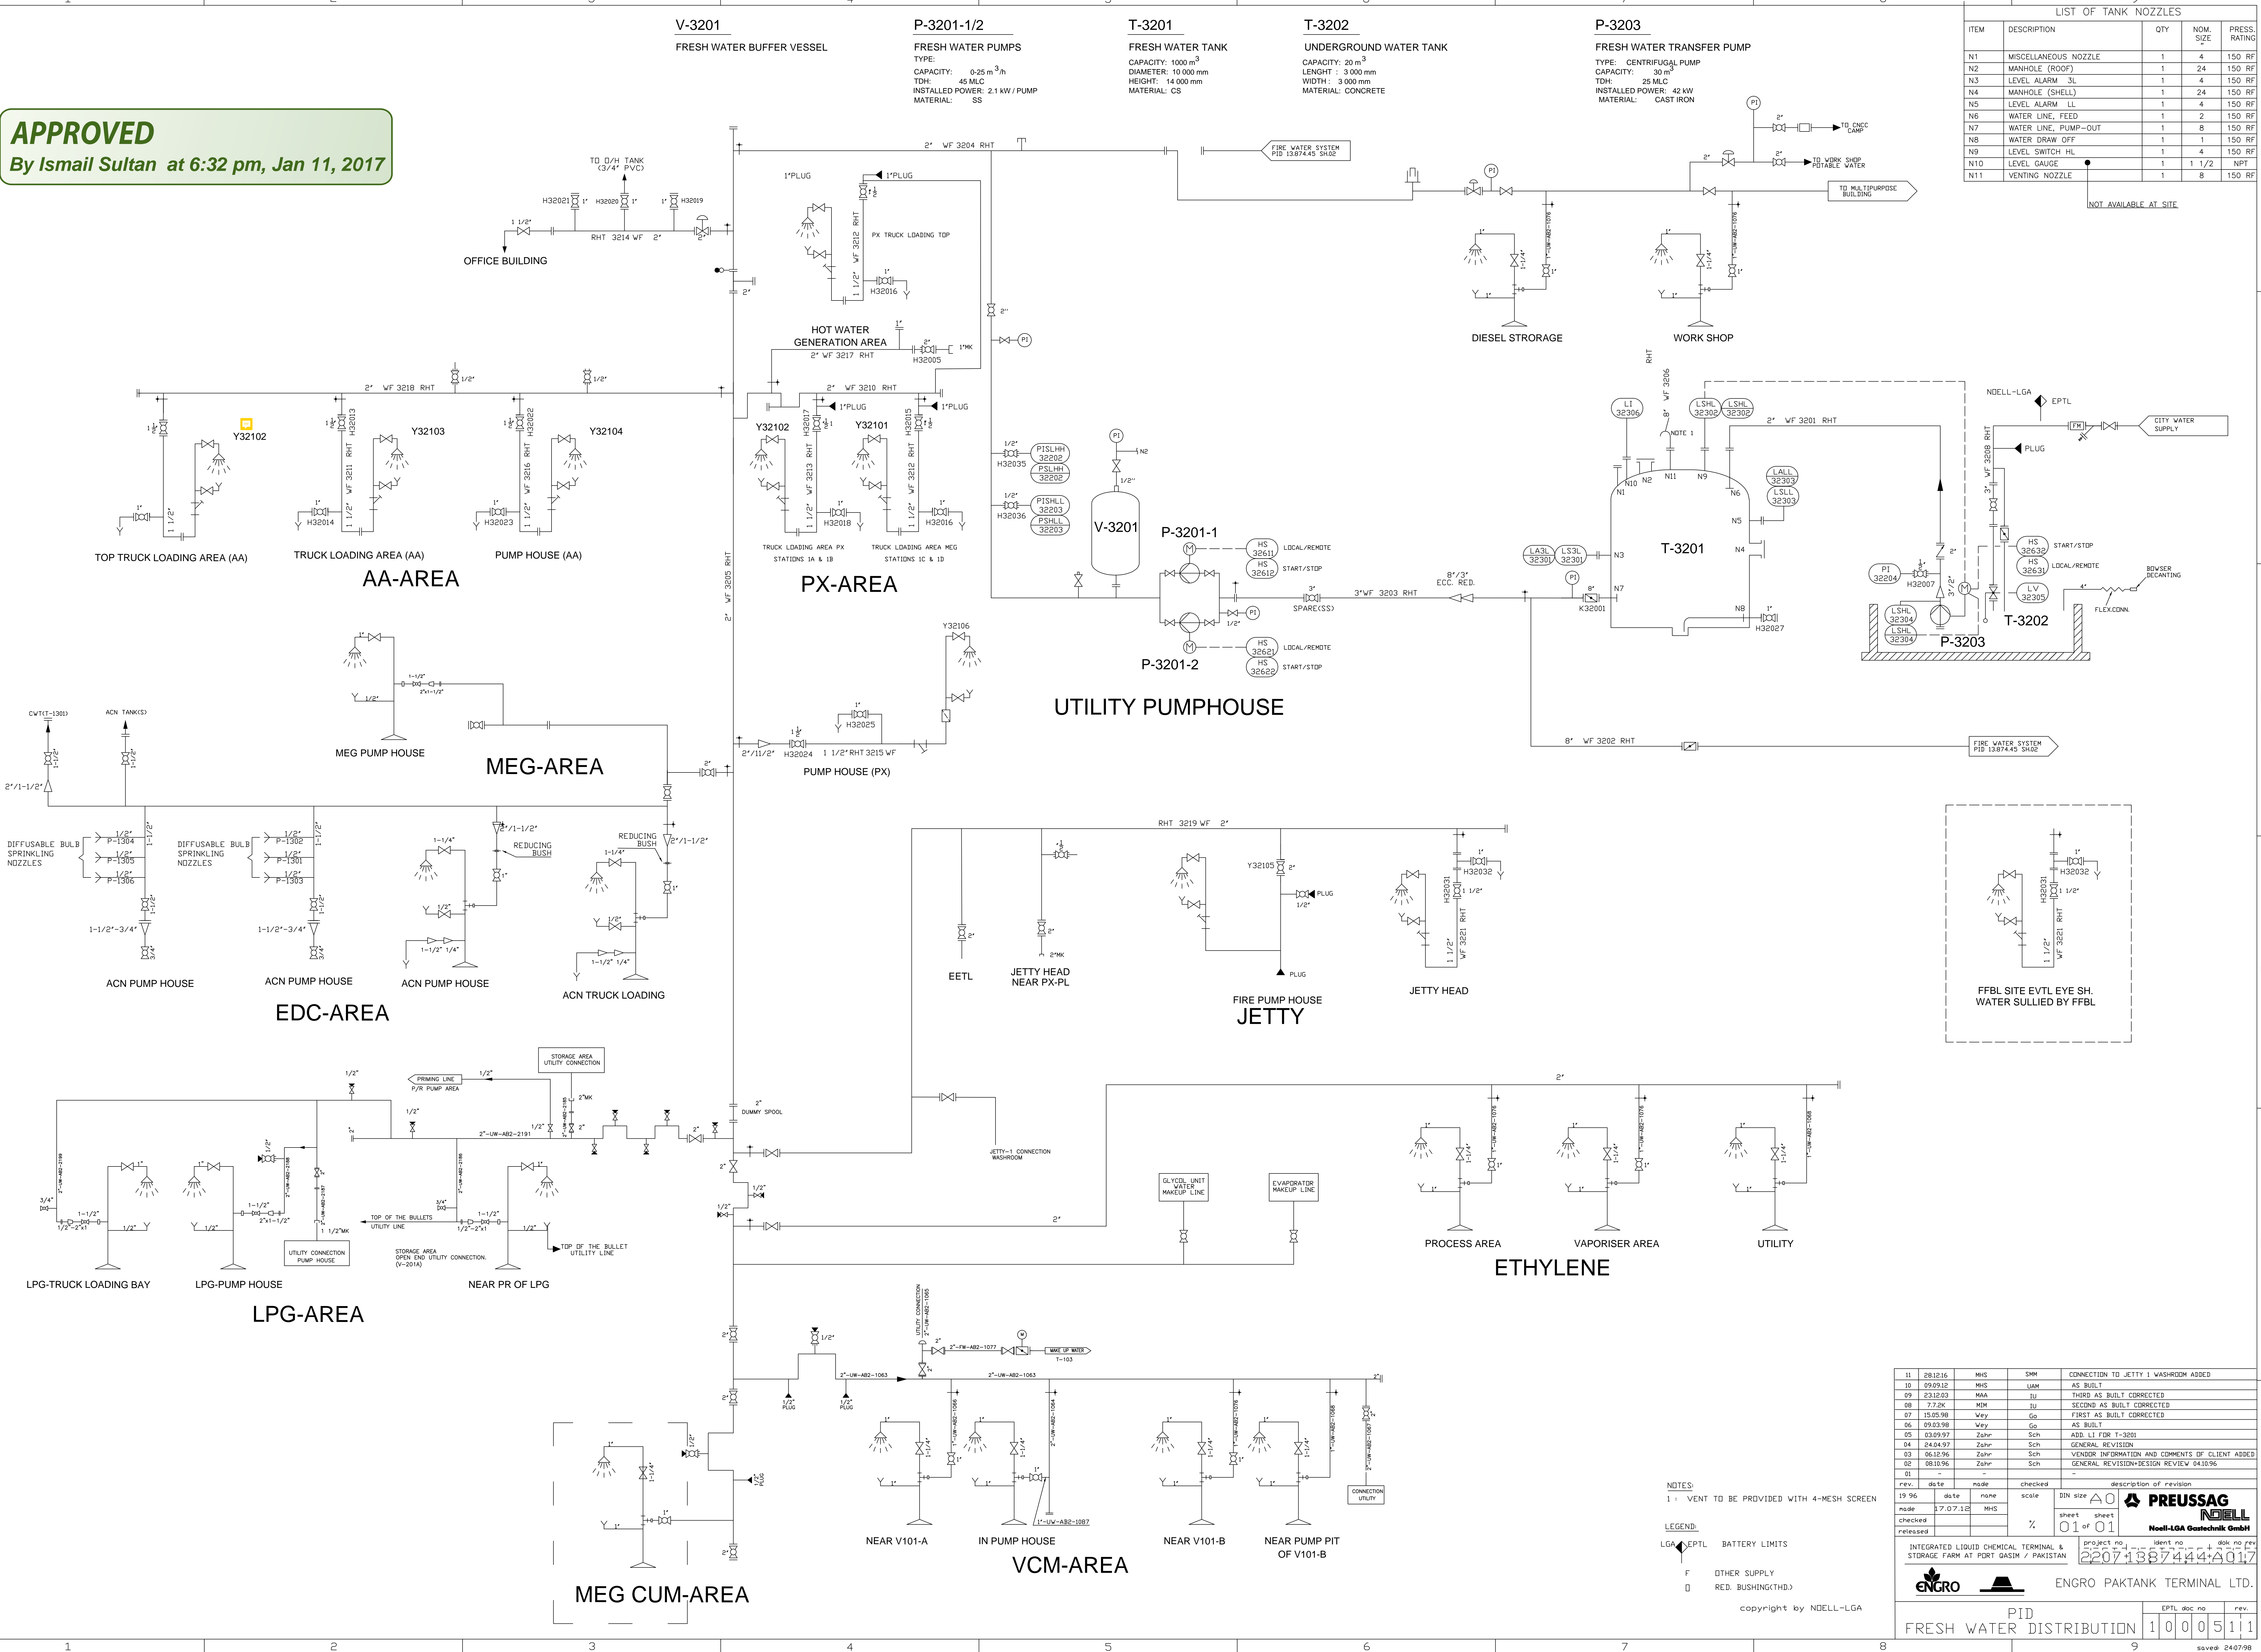

*By Ismail Sultan at 6:32 pm, Jan 11, 2017*

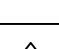

LIST OF TANK NOZZLES				
ITEM	DESCRIPTION	QTY	NOM. SIZE	PRESS. RATING
N1	MISCELLANEOUS NOZZLE	1	4	150 RF
N2	MANHOLE (ROOF)	1	24	150 RF
N3	LEVEL ALARM 3L	1	4	150 RF
N4	MANHOLE (SHED)	1	24	150 RF
N5	LEVEL ALARM LL	1	4	150 RF
N6	WATER LINE, FEED	1	2	150 RF
N7	WATER LINE, PUMP-OUT	1	8	150 RF
N8	WATER DRAFF OFF	1	1	150 RF
N9	LEVEL SWITCH HL	1	4	150 RF
N10	LEVEL GAUGE	1	1 1/2	NPT
N11	VENTING NOZZLE	1	8	150 RF

11	28.12.16	MHS	SMM	CONNECTION TO JETTY 1 WASHROOM ADDED	
09	09.09.12	MHS	UAM	AS BUILT	
09	23.02.03	MAA	JU	THIRD AS BUILT CORRECTED	
07	7.12.02	MCH	JU	SECOND AS BUILT CORRECTED	
08	15.05.98	Vey	Go	FIRST AS BUILT CORRECTED	
06	09.03.98	Vey	Go	AS BUILT	
03	03.09.87	Zahr	Sch	ADD. LT FOR T-3201	
04	24.04.97	Zahr	Sch	GENERAL REVISION	
03	06.12.96	Zahr	Sch	VENDOR INFORMATION AND COMMENTS BY CLIENT ADDED	
02	08.10.96	Zahr	Sch	GENERAL REVISION DESIGN REVISED 04/10/96	
D1	—	—	—	—	

rev.	date	name	checked	description of revision	
19	date	name	scale	DIN size 	
name	27.07.12	MHS		 	
released			%	sheet	
				01	of 01

project no.      sent no.      dok no. rev.

2207-1387444-01017

NOELL-LGA Gastechnik GmbH

INTEGRATED LIQUID CHEMICAL TERMINAL & STORAGE FARM AT PORT GASMIS / PAKISTAN

ENGRO PAKTANM TERMINAL LTD.

PID		EPTL doc no.		rev.	
FRESH	WATER	DISTRIBUTION	1	0	0
			5	1	1

9

saved 24/07/96