


ST-202

VENT STACK (JETTY)

DIM: 12"/3" DIA X 10M HT.

DESIGN: 7.0 BARG, 60/-42C°

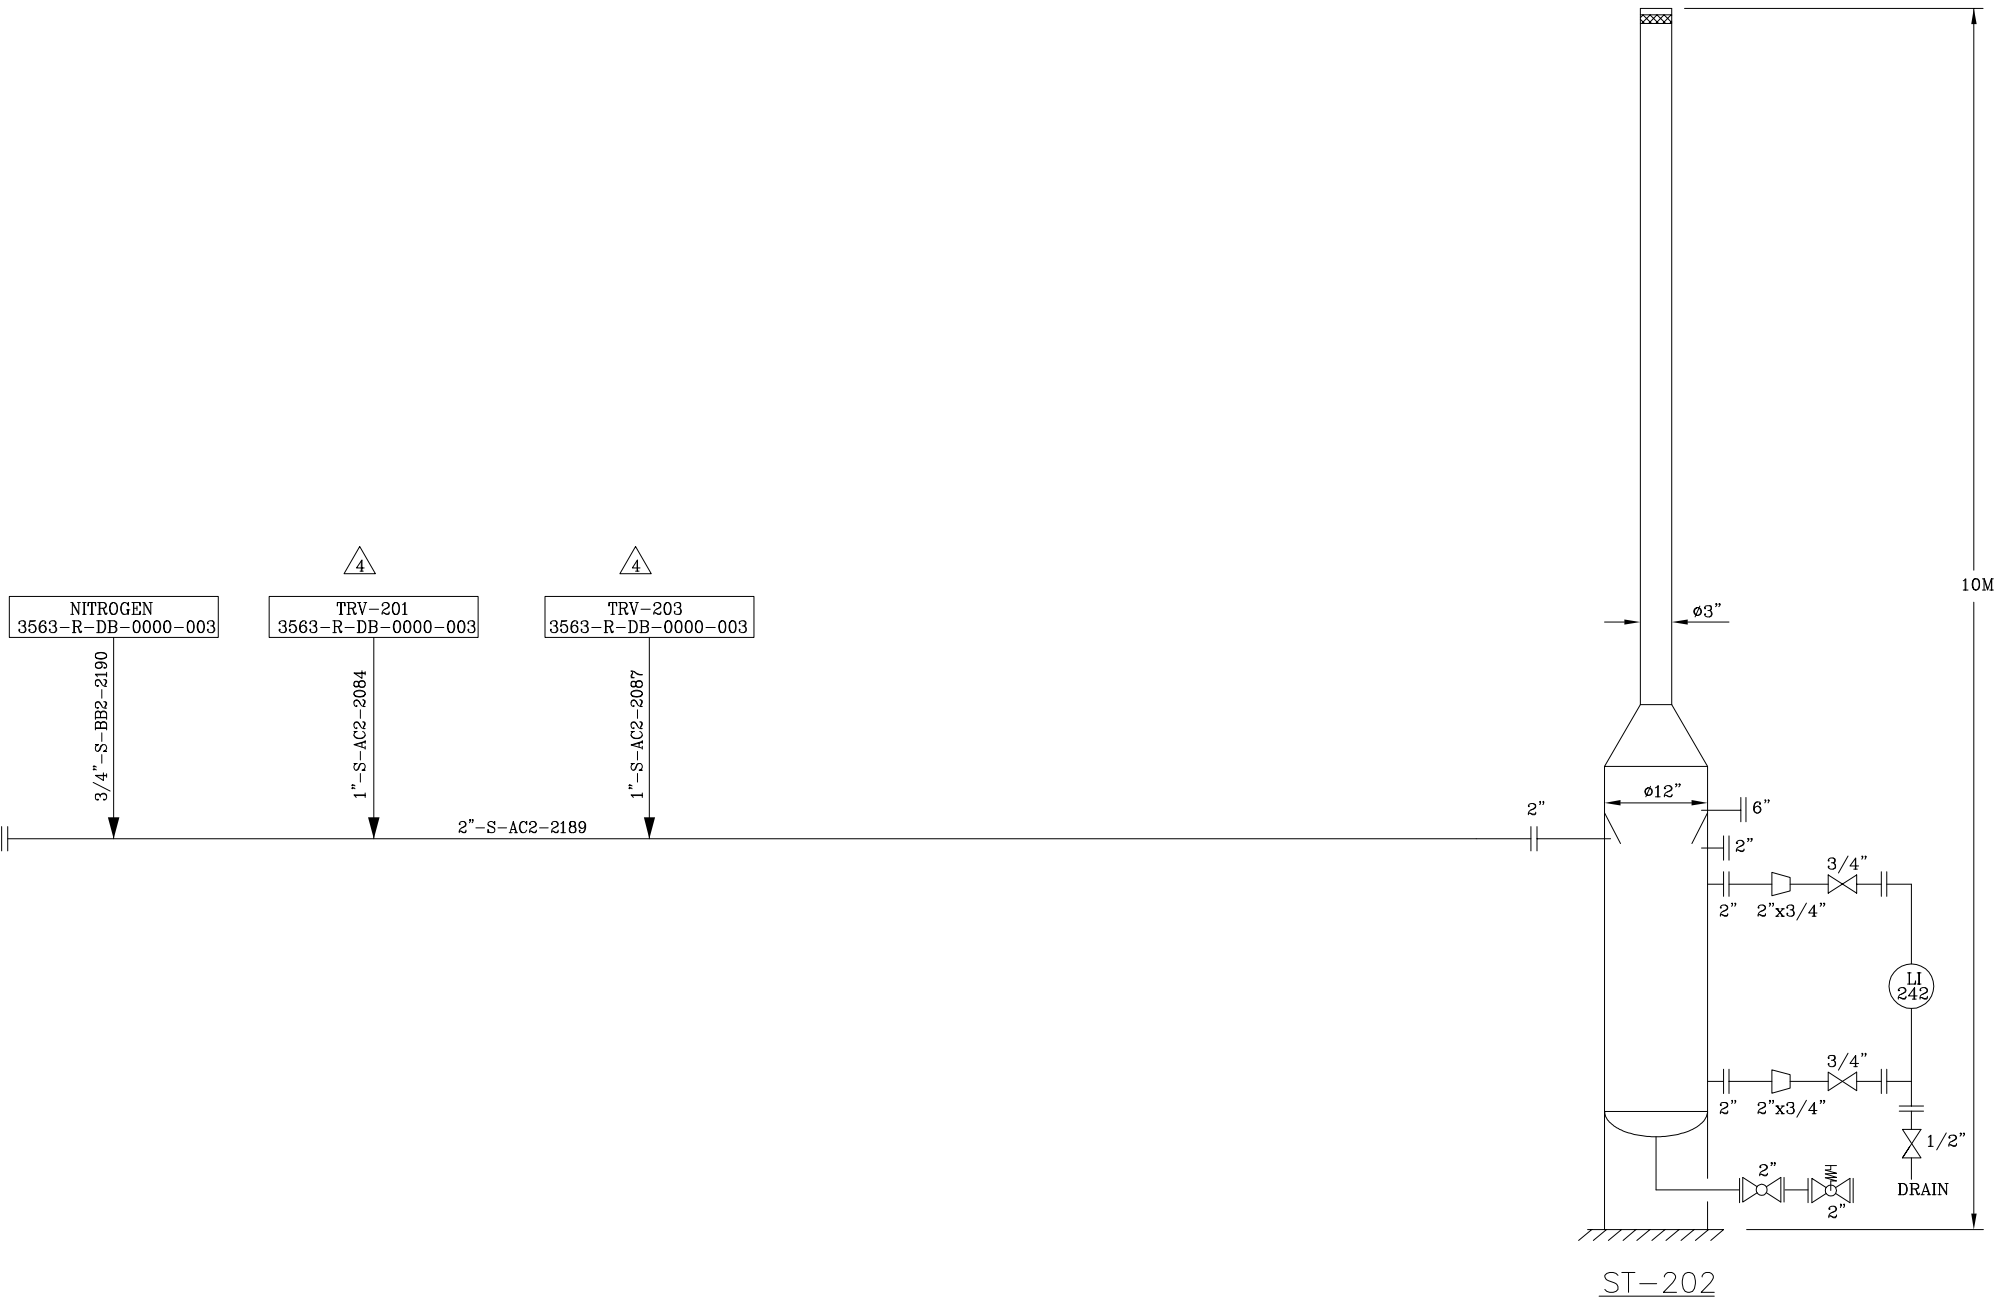

NOTE (S):

- REFER P & ID 3563-R-DB-0000-002 FOR LEGEND AND GENERAL NOTES.
- VENT STACK IS BUILT WITH LPG PROJECT AND SAME WILL BE USED FOR VCM VAPORS ALSO.

7	24.09.09	AS BUILT	SZH		BIK		-	
6	26.12.03	SECOND AS BUILT	MAA		IU		SNR	
5	7.7.2K	FIRST AS BUILT	MIM		IU		SNR	
4	06-12-99	AS BUILT	YM		ZM		IA	
3	08-03-99	ISSUED FOR CONSTRUCTION	YM		ZM		MH	
2	22-02-99	ISSUED FOR CONSTRUCTION	YM		ZM		MH	
REV	DATE	DESCRIPTION	INIT. BY	SIGN	INIT. CHK'D	SIGN	INIT. APP'VD	SIGN
REVISIONS								
UNAUTHORIZED REPRODUCTION OF ANY KIND IS PROHIBITED; ALL RIGHTS ARE RESERVED BY DESCON ENGINEERING LIMITED, LAHORE, PAKISTAN								



DESCON ENGINEERING LTD.
P.O. BOX 1201, LAHORE 54000, PAKISTAN

ORIGINAL	INT.	SIGN	DATE
ENGINEERED	RZA		6/12
DRAWN	YM		6/12
CHECKED	ZM		6/12
APPROVED	IA		6/12

THIS DOCUMENT HAS BEEN
MODIFIED MANUALLY
☐ YES ☒ NO

EPTL DOC. NO.
DR 04 905

CLIENT	ENGRO	ENGRO PAKTANK TERMINAL LTD.
PROJECT LPG STORAGE & HANDLING		
TITLE P & ID STACK ON JETTY SIDE		
DOCUMENT NUMBER 3563-R-DB-0000-049-*		SHEET NO OF 1 1
		REV. 7

APPROVED

By Ismail at 9:59 am, Dec 17, 2014